

ADDENDUM NO. 2

Project: Alberton Water Improvements Project
Owner: Town of Alberton, Montana
607 Railroad Ave.
Alberton, MT 59820
Engineer: Anderson-Montgomery Consulting Engineers
1064 N. Warren
Helena, MT 59601

Date of Addendum: April 22, 2024

Bid Opening Date: April 23, 2024

The following corrections, clarifications, and/or alterations to the specifications for the project are as such a part and parcel of said plans and specifications as if included therein.

Modifications to language in drawings and technical specifications shall be as follows:

- Language that is to be removed will be shown as ~~stricken~~
- Language that is to be added or clarified will be shown as **bold underlined**
- Comments & clarifications are in italics

TECHNICAL SPECIFICATIONS:

1. Specification Section 01 50 00 – TEMPORARY FACILITIES AND CONTROL (Addition)

1.07 FIELD OFFICES (~~as needed~~)

C. Contractor shall provide the Engineer’s Inspector a weathertight, lighted, heated, ventilated, secure office space, furnished with a chair and work desk – for the duration of the project.

2. Specification Section 00 90 00 – FUNDING AGENCY SPECIAL PROVISIONS FOR MONTANA PUBLIC FACILITY PROJECTS (Clarification)

*The Build America, Buy America Act (BABAA) provisions outlined in section 1.3.4 are stricken since this project is not funded through USDA/RUS. **However, note that the BABAA provisions in SRF under Section 1.5.10 and Exhibit E are fully applicable.***

DRAWINGS:

1. Drawing D-2 – Underground Power

Northwestern Energy recently located an underground primary power line at approximate Sta 7+63 on Sheet D-2. Contractors will be compensated at the Bid Item #170 for crossing this utility. Bids will (still) be evaluated based on the current estimate of 28 utility crossings.

ATTACHMENTS:


Attached for the bidder’s information are the following:

1. Latest Planholders List
2. Updated Sheet D-2

Please Remember To Note Receipt Of This Addendum On The Bid Form. Failure To Do So Will Result In Disqualification.


Issued By: ANDERSON-MONTGOMERY, 1064 N. WARREN, HELENA, MT 59601,

Paul Montgomery, P.E., Project Manager

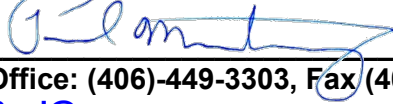

Office: (406)-449-3303, Fax (406)-449-3304
Paul@a-mce.com

END OF ADDENDUM NO. 2


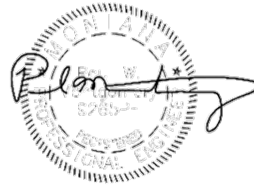


Water Improvements Project
Town of Alberton
April 2024
Anderson-Montgomery Consulting Engineers

PLANHOLDERS' LIST

PLAN SET #	HOLDER	DATE SENT	PAID
1	Prospect Construction Lori Bennet lbennett@prospectconst.com 406-493-1300	4/4/2024	N/A
2	Western Municipal Construction Danielle Thompson dthompson@wmc-i.com 406-254-2106	4/4/2024	N/A
3	Razz Construction Michelle Biles michelleb@razzconstruction.com 360-752-0011	4/4/2024	N/A
4	Mike Coleman Construction Jenae Prestridge mcolemanconstruction@gmail.com 406-683-3489	4/4/2024	N/A
5	3 Rivers Land Works Brian/Kelly 14286 Turah Rd Clinton, MT 59825 admin@3riverslandworks.com 406-396-2051	4/4/2024	Ck #2163
6	S&L Underground, Inc. 66304 Highway 2 Bonners Ferry, ID 83805 admin@slunder.com	4/6/2024	N/A
7	RLC Enterprise Connor Buckley 5562 Alloy S, Unit D Missoula, MT 59808 Connor@rlcent.com 406-544-6046	4/22/2024	Check mailed 4/22/24

X:\ALBERTON_WATER\DESIGN DRAWINGS - RE-BID\Sheets\Alberton Border - Addendum 2.dwg SAVED: 4/17/24 PRINTED: 5/8/19 BY: ADAM

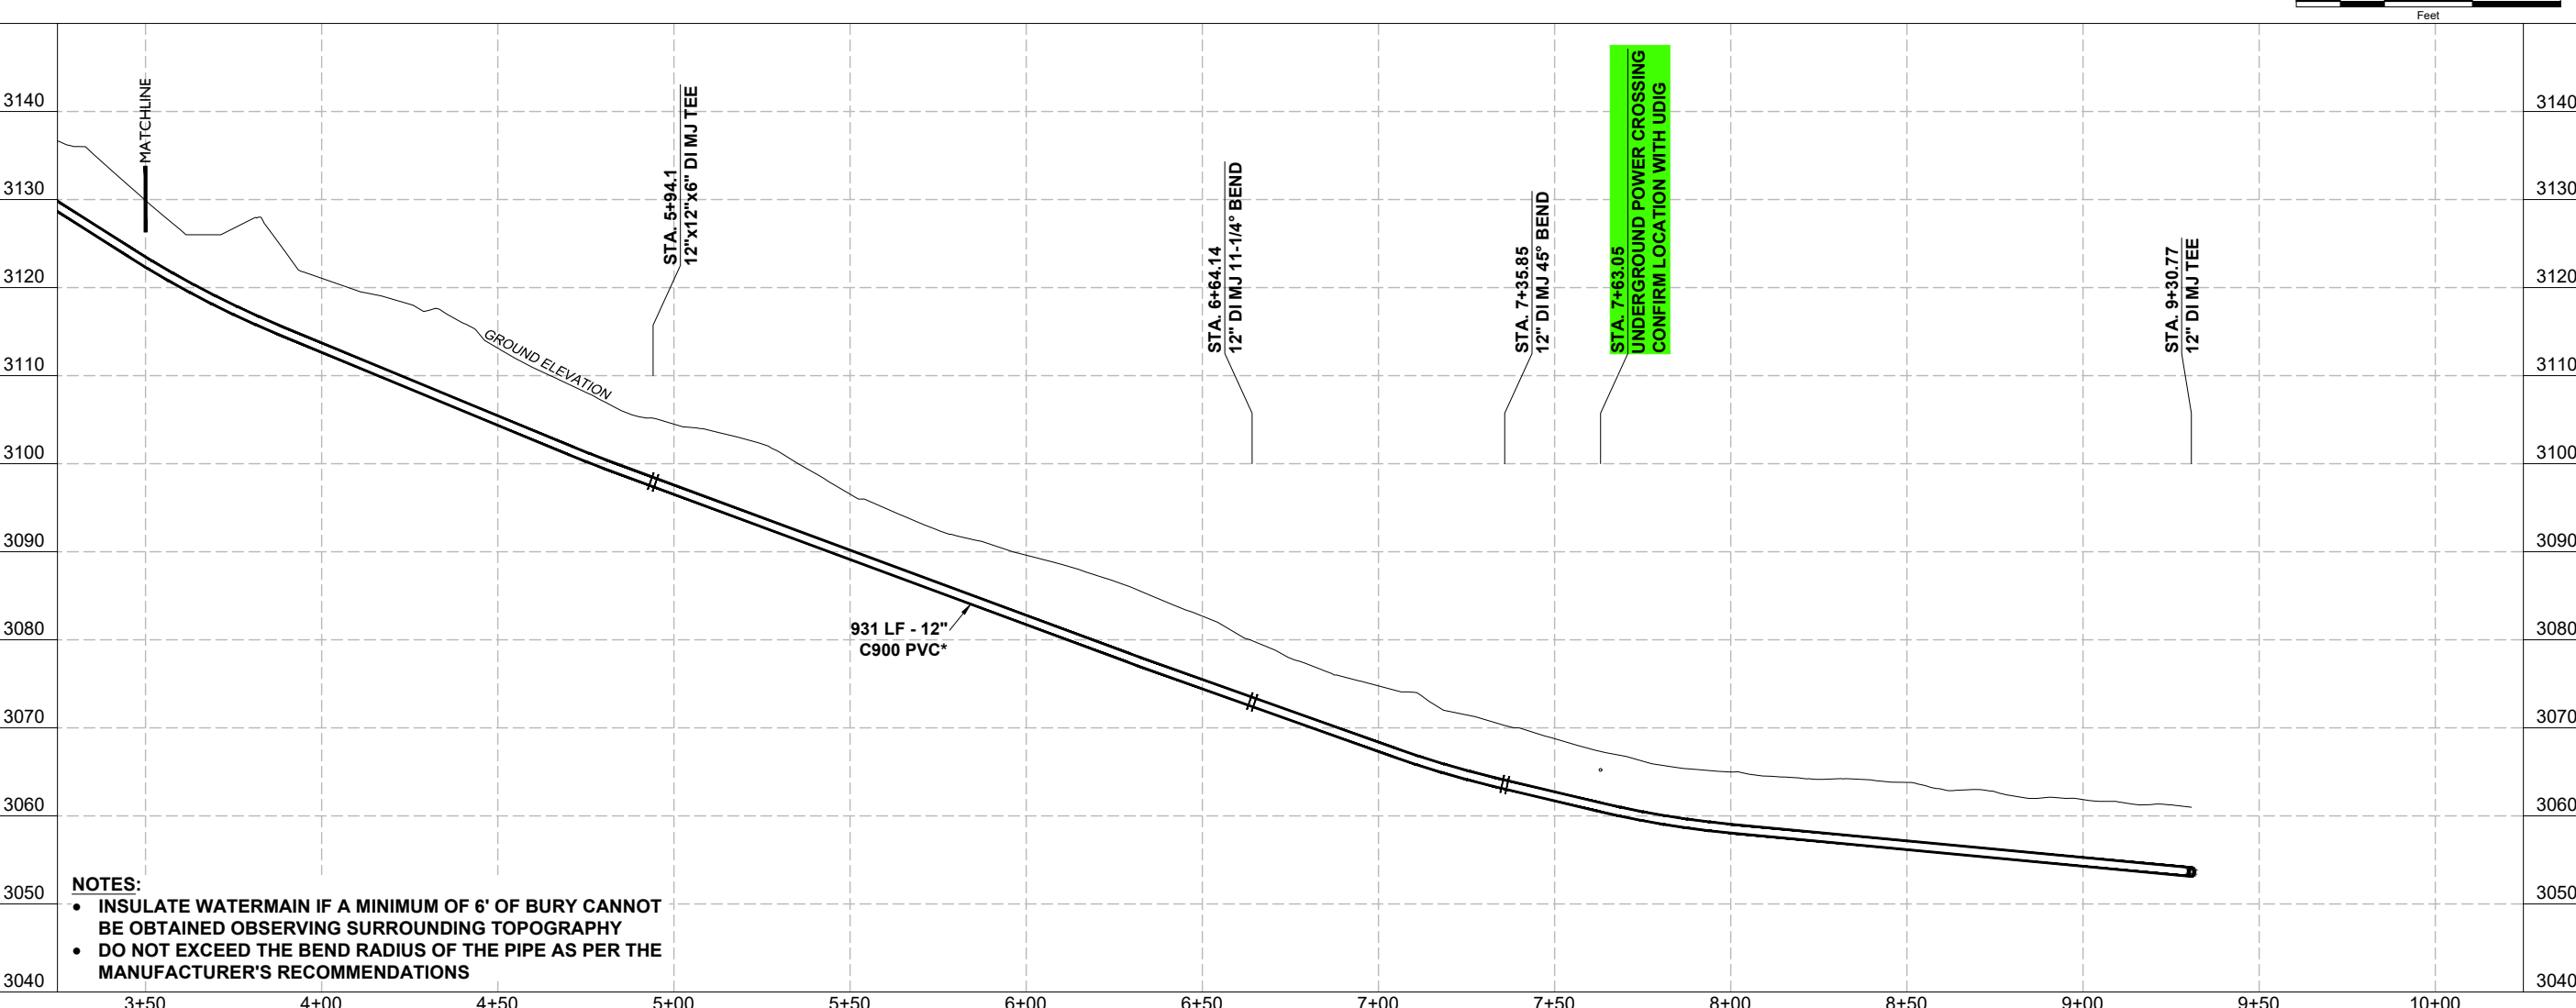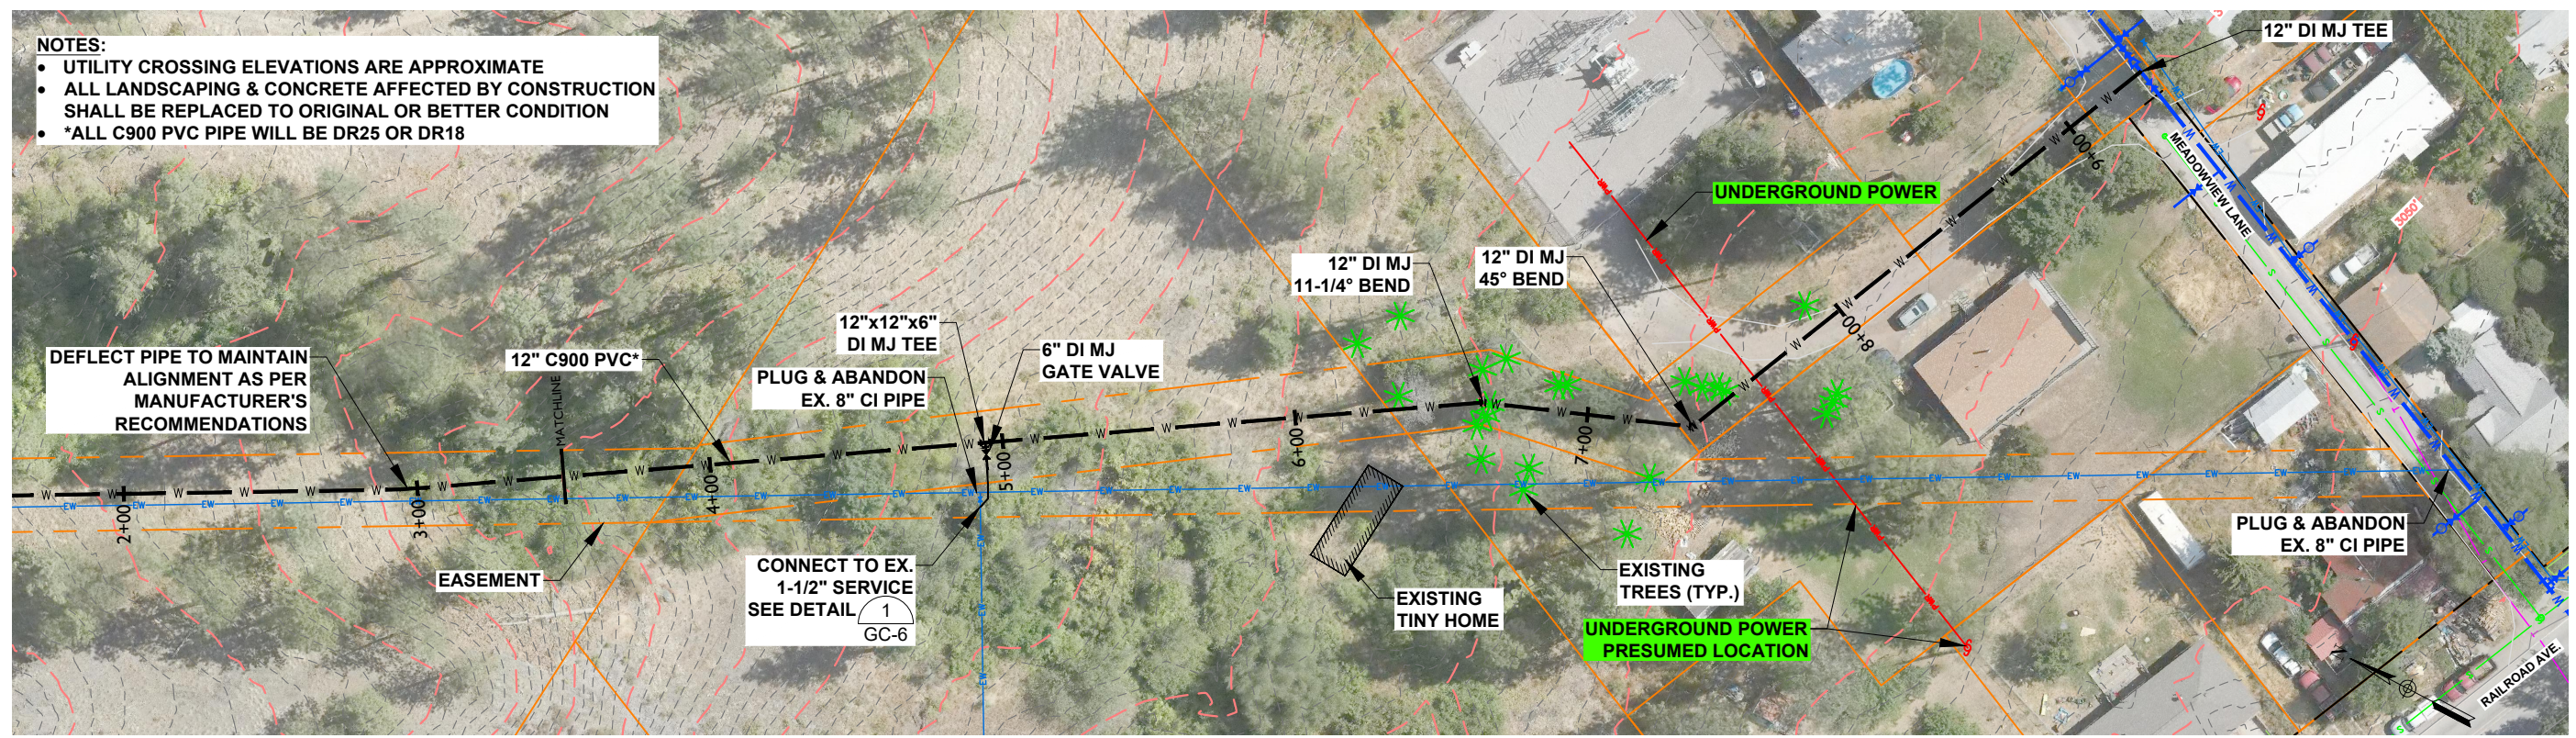

NOTES:

- UTILITY CROSSING ELEVATIONS ARE APPROXIMATE
- ALL LANDSCAPING & CONCRETE AFFECTED BY CONSTRUCTION SHALL BE REPLACED TO ORIGINAL OR BETTER CONDITION
- *ALL C900 PVC PIPE WILL BE DR25 OR DR18

DEFLECT PIPE TO MAINTAIN ALIGNMENT AS PER MANUFACTURER'S RECOMMENDATIONS

EASEMENT



CONNECT TO EX. 1-1/2" SERVICE SEE DETAIL GC-6

EXISTING TINY HOME

EXISTING TREES (TYP.)

UNDERGROUND POWER

UNDERGROUND POWER PRESUMED LOCATION

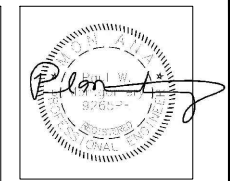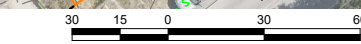

Revision	Date	By
Draft	8-11-23	PWM
Final Draft	12-14-23	PWM
Final	2-5-24	PWM
Final Re-Bid	4-1-24	PWM
Add. #2	4-17-24	PWM

Revision Addendum #2 Re-Bid
 Plot Scale 1:2
 Drawn By A. Eckhart, P.E.
 Approved By P. Montgomery, P.E.
 Checked By A. Eckhart, P.E.
 Designed By P. Montgomery, P.E.

Engineer

 Anderson-Montgomery
 CONSULTING ENGINEERS
 1064 N. Warren
 Helena, Mt 59601
 Phone (406) 449-3303
 Fax (406) 449-3304

Owner
 Town of Alberton

Project Title
 Alberton Water System Improvements Project

Sheet Title
 New Potable Water Plan & Profile
 Storage Tank to Distribution Continued

Sheet
D-2